


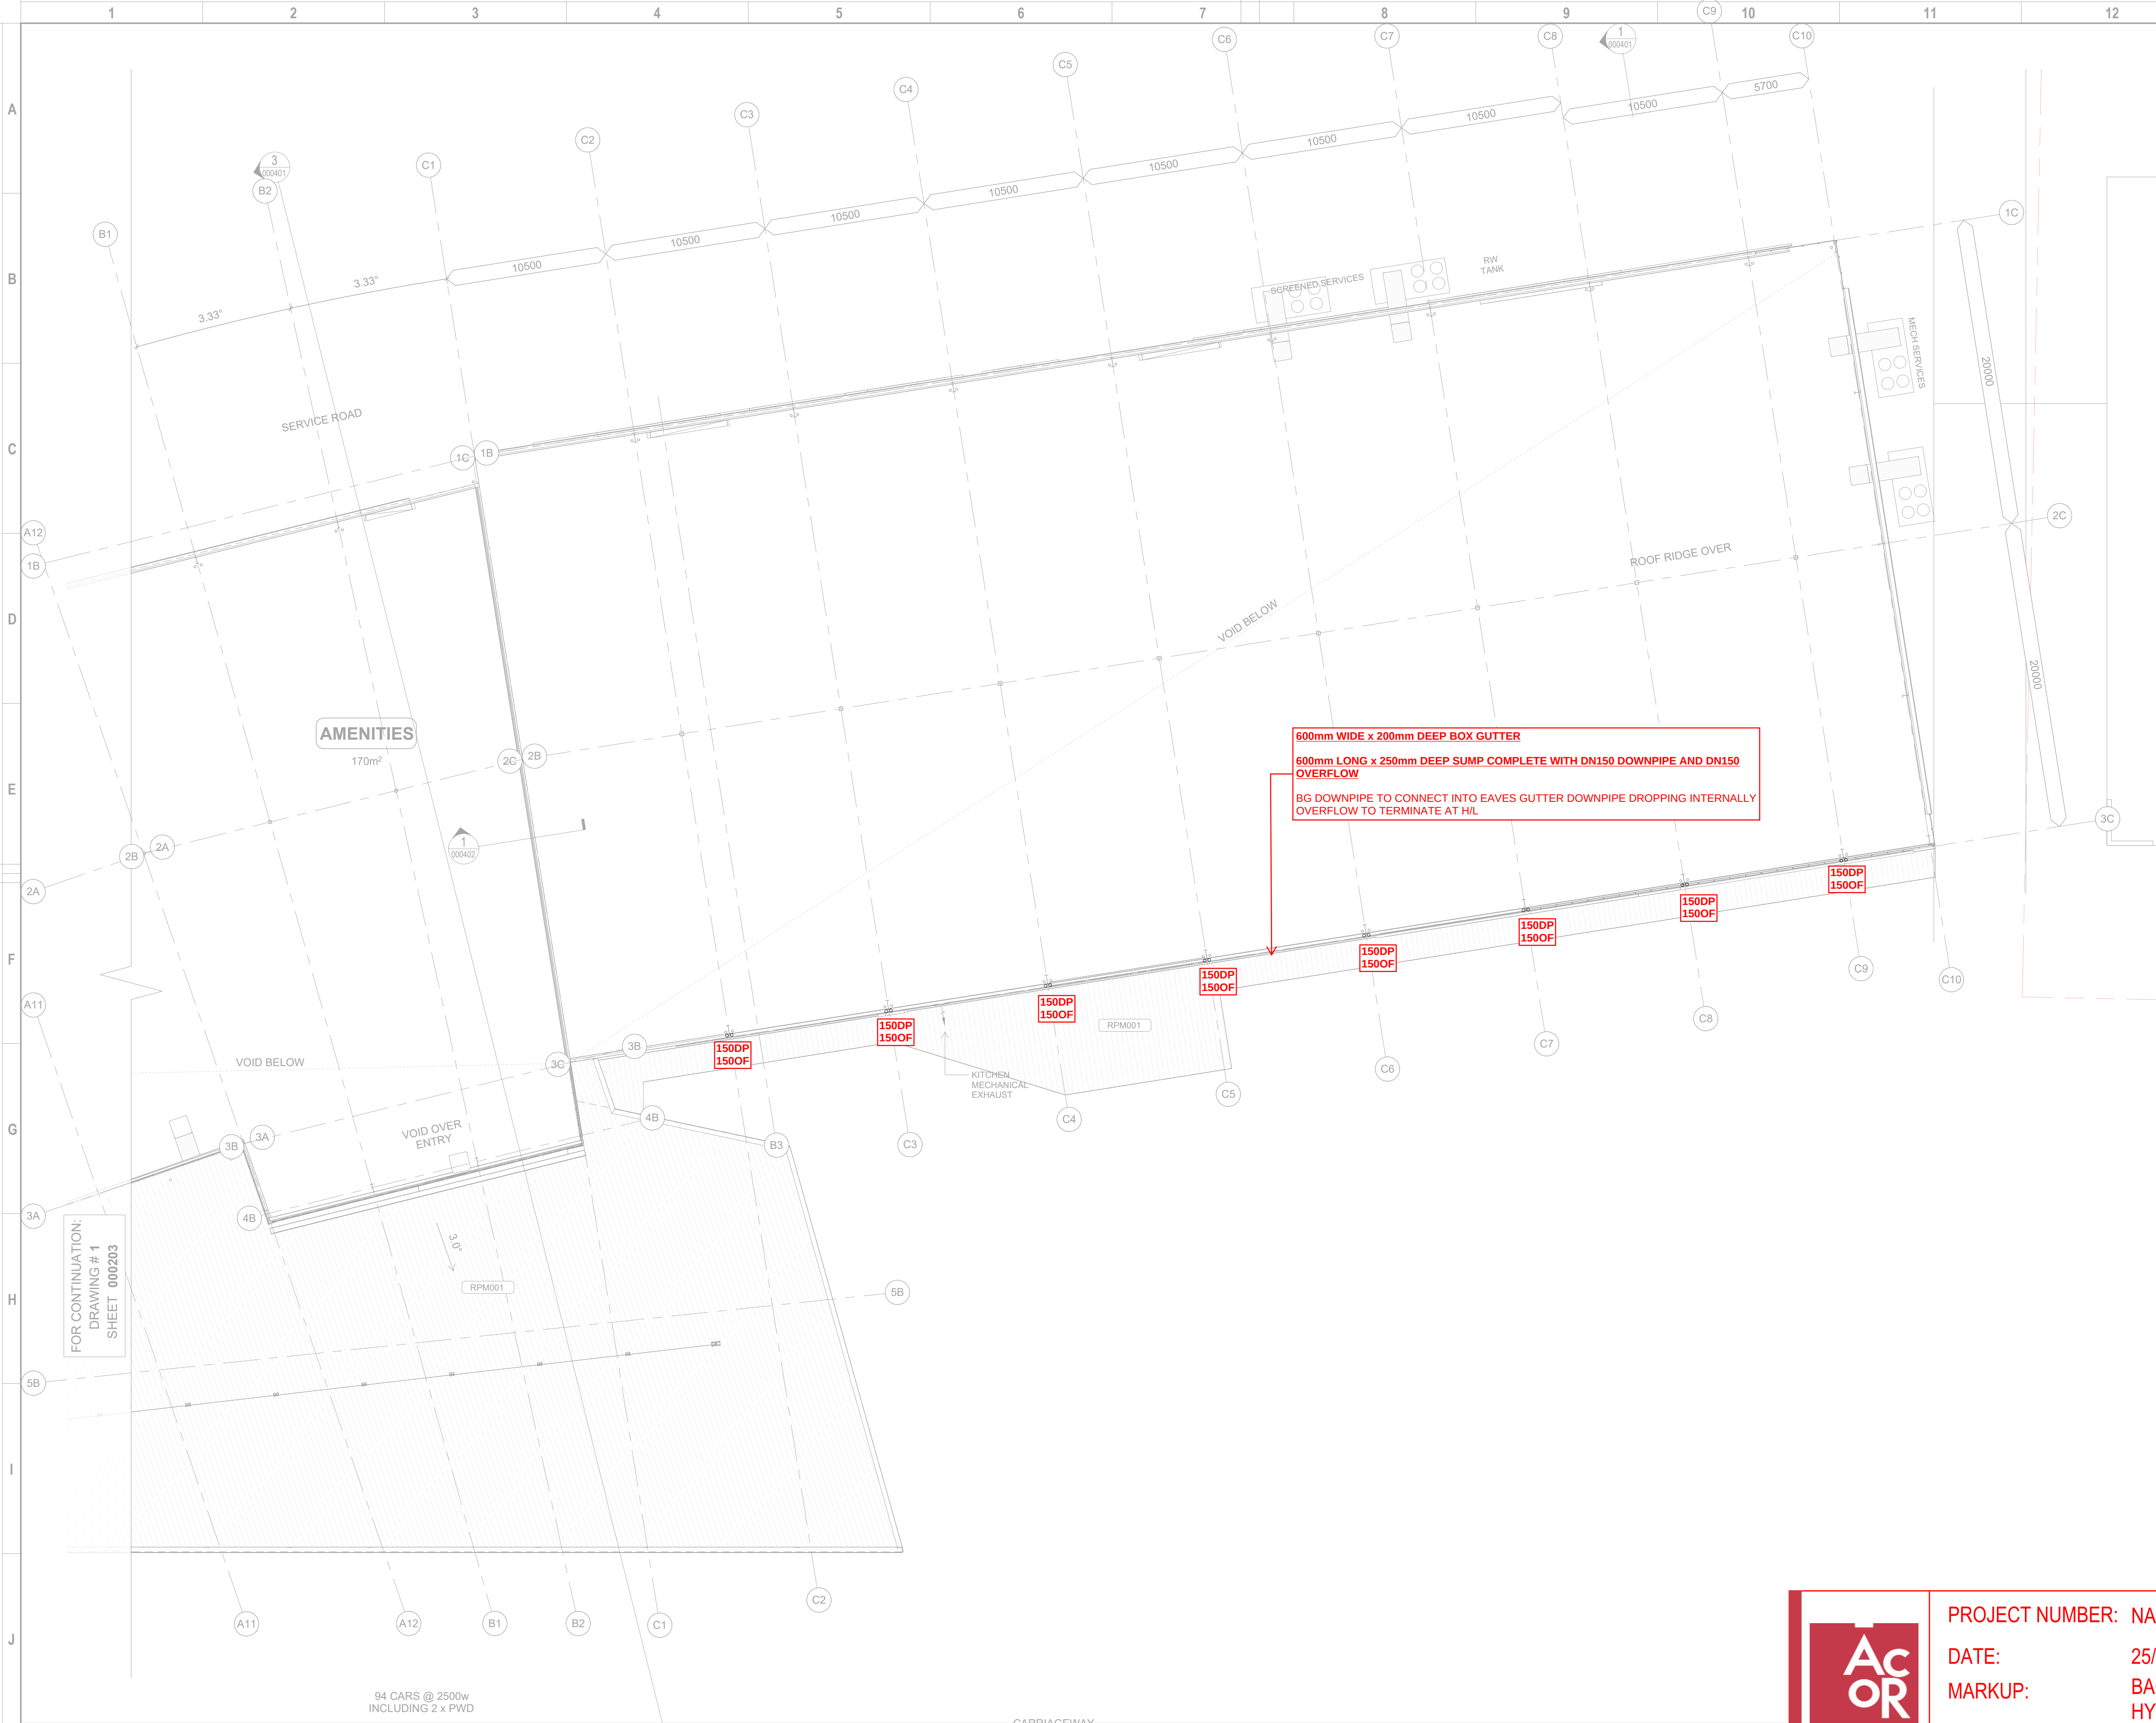

COPYRIGHT:
REPRODUCTION OF WHOLE OR PART OF THIS DOCUMENT
CONSTITUTES AN INFRINGEMENT OF COPYRIGHT. THE
INFORMATION, IDEAS AND CONCEPTS CONTAINED IN THIS
DOCUMENT ARE CONFIDENTIAL. THE RECIPIENT(S) OF
THIS DOCUMENT IS PROHIBITED FROM DISCLOSING SUCH
INFORMATION IDEAS AND CONCEPTS TO ANY PERSON
WITHOUT THE PRIOR WRITTEN CONSENT OF THE
BRISBANE AIRPORT CORPORATION PTY. LTD.

DRN	AMENDMENTS	DATE	REV
JB	FOR COORDINATION	04.12.2025	1
DC	FOR COORDINATION	21.01.2026	2
JB	60% DD ISSUE 2	05.02.2026	3

TAG LEGEND

CLD004	PROFILED METAL SHEET CLADDING - REFER TO SECTION J REPORT
CLD005	DANPALON SINGLE GLAZED TRANSLUCENT CLADDING
CLD006	PRECAST CONCRETE
COL	STRUCTURAL COLUMN - REFER STRUCTURAL ENGINEER
DP	DOWNPIPE
GT01	COLORBOND FOLDED STEEL GUTTER
MEC001	MECHANICAL DUCT - REFER MECHANICAL ENGINEER
RPM001	INSULATED ROOF PANEL
RS001	ROOF SAFETY SYSTEM
STR001	STRUCTURAL COLUMN - REFER STRUCTURAL ENGINEER

Archipelago

Archipelago
Level 3, 159 George Street, Brisbane QLD 4000
T +617 3236 4806 www.archipelago.com.au
© ARCHIPELAGO ARCHITECTS PTY. LTD. All Rights Reserved
This work is copyright and cannot be reproduced or copied by any means without written permission of Archipelago Architects Pty Ltd. Any
license, express or implied, to use this document for any purpose
whatsoever is restricted to the terms of the agreement between Archipelago Architects P
y Ltd and the instructing party.

SKYGATE PLAY

GENERAL ARRANGEMENT - PART B - HIGH LEVEL

Drawn JB	Checked DC
Design Coordinated	Compliance Checked
Authorised For Issue	Construction Checked



PROJECT NUMBER: NA260549
DATE: 25/05/2025
MARKUP: BAC SKYGATE PLAY
HYDRAULIC SERVICES PRELIM SKETCH