


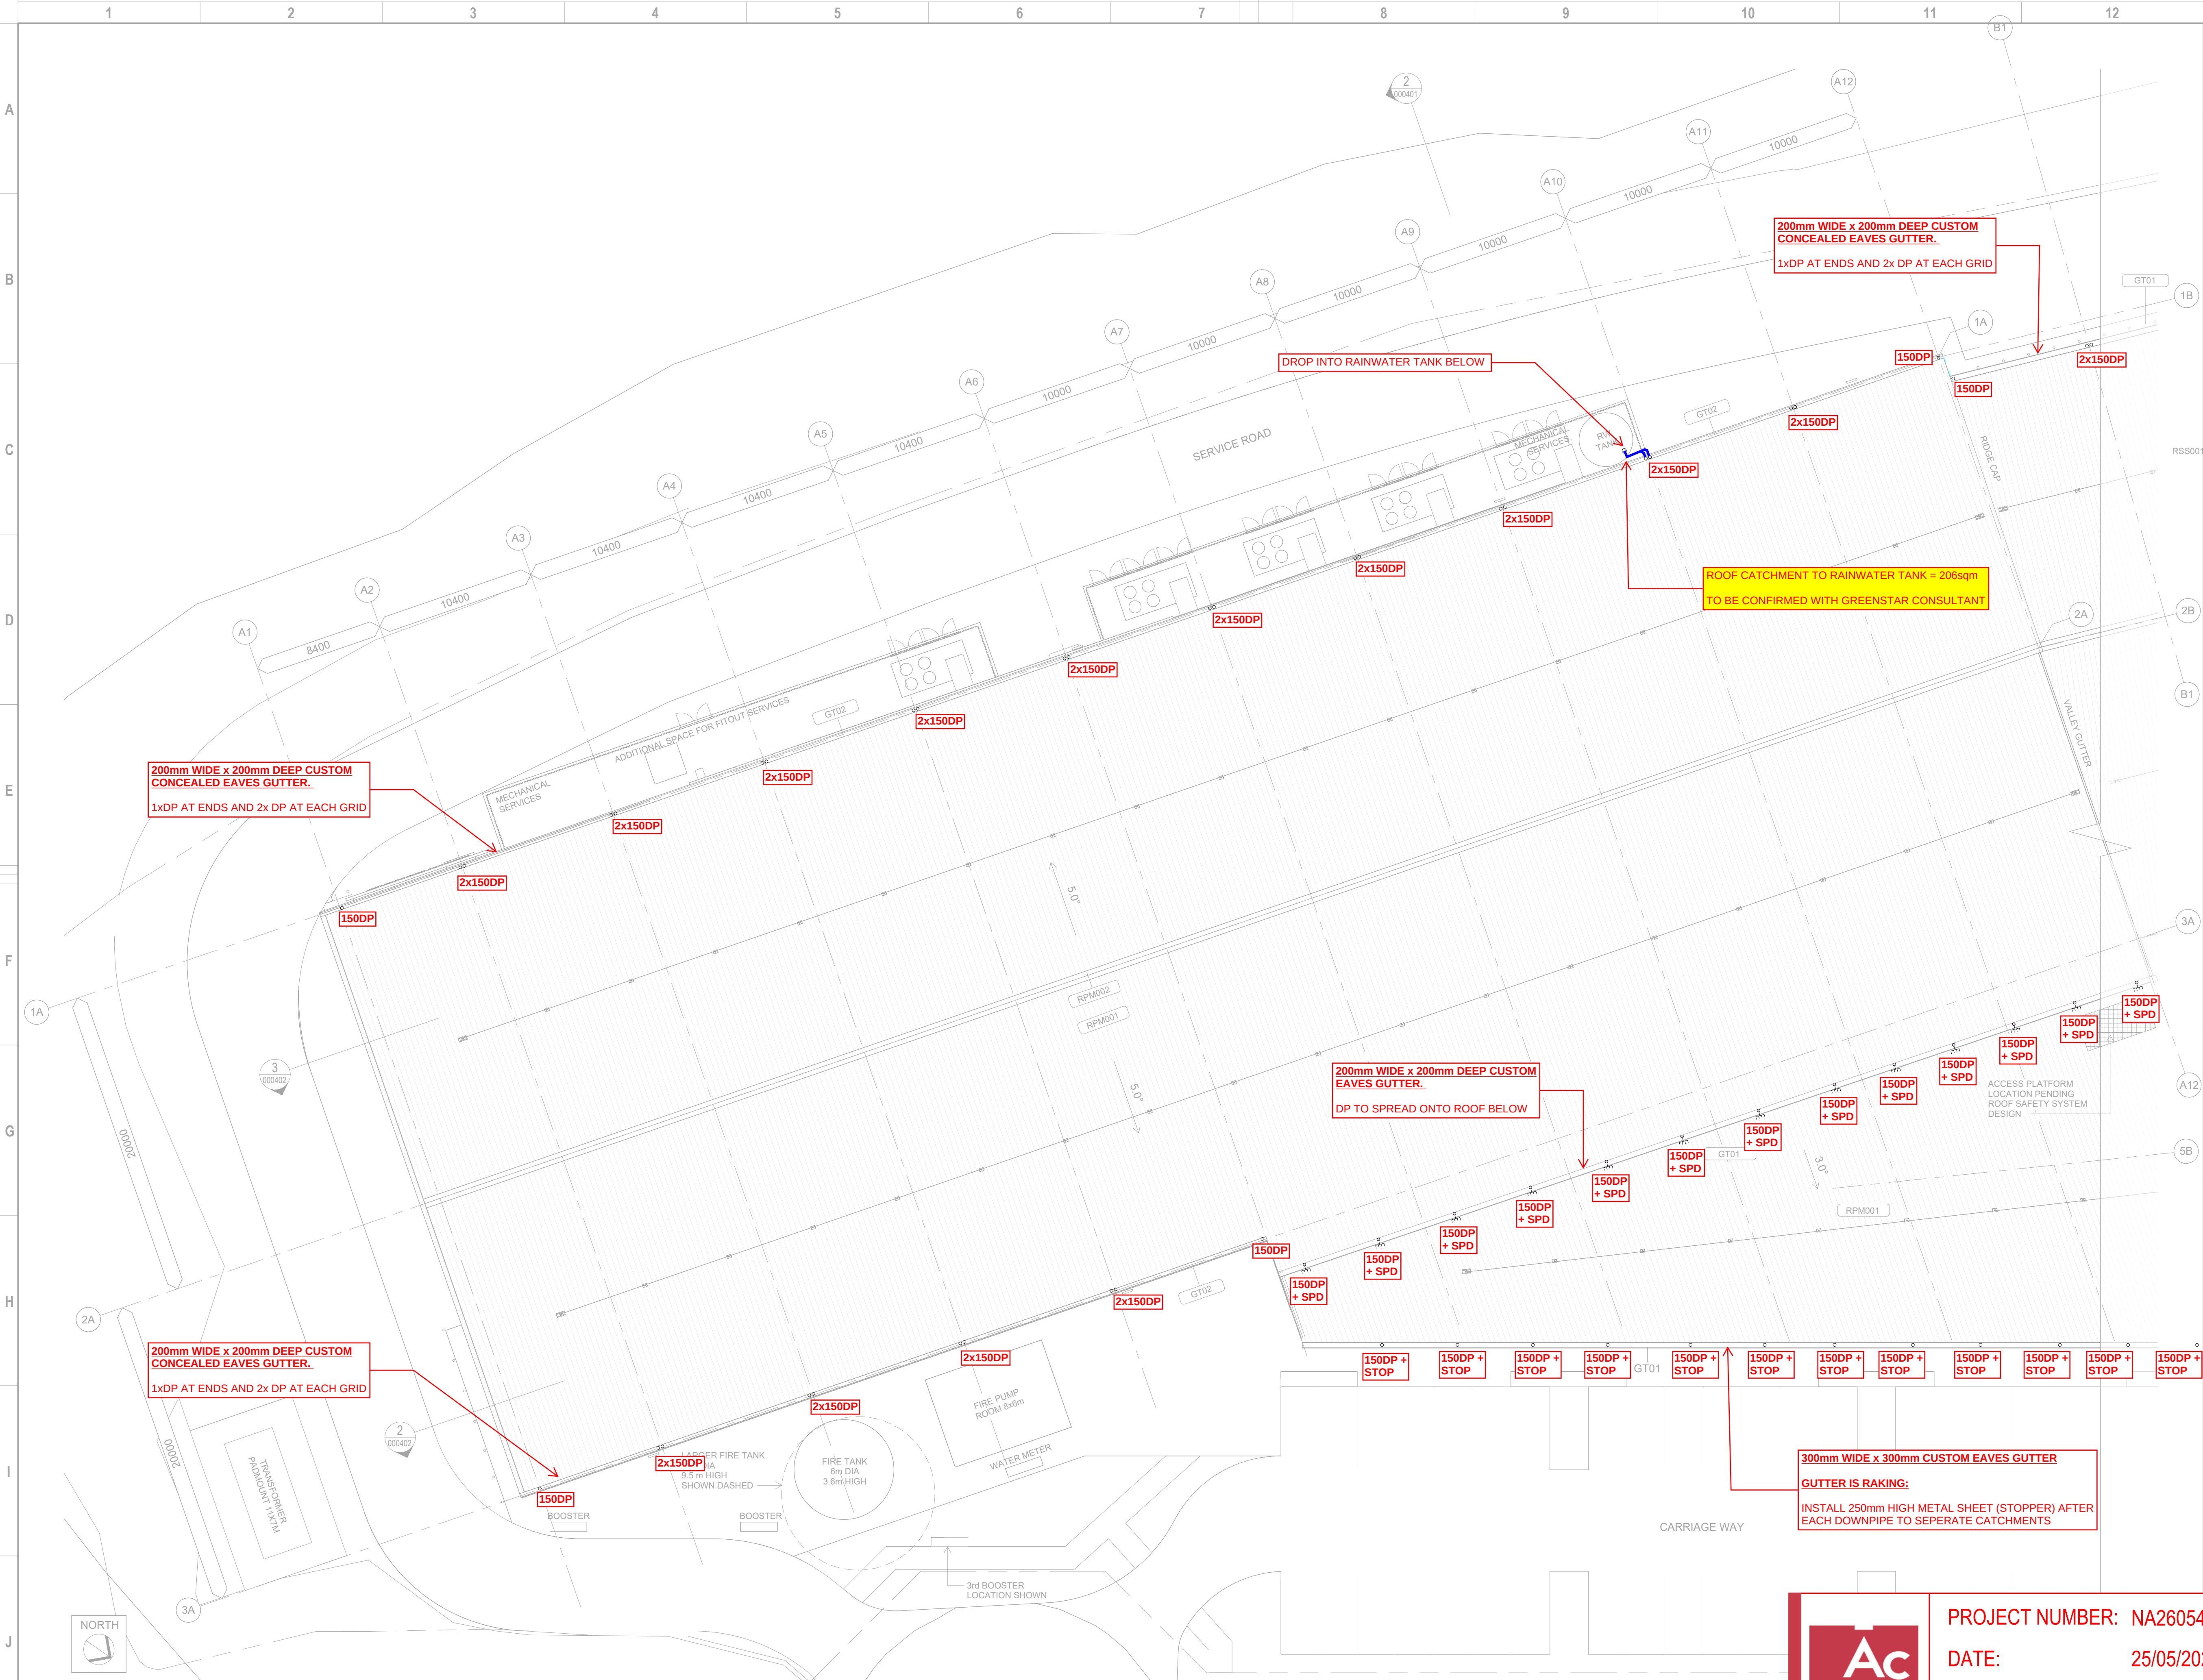

COPYRIGHT:
REPRODUCTION OF WHOLE OR PART OF THIS DOCUMENT
CONSTITUTES AN INFRINGEMENT OF COPYRIGHT. THE
INFORMATION, IDEAS AND CONCEPTS CONTAINED IN THIS
DOCUMENT ARE CONFIDENTIAL. THE RECIPIENT(S) OF
THIS DOCUMENT IS PROHIBITED FROM DISCLOSING SUCH
INFORMATION IDEAS AND CONCEPTS TO ANY PERSON
WITHOUT THE PRIOR WRITTEN CONSENT OF THE
BRISBANE AIRPORT CORPORATION PTY. LTD.

DRN	AMENDMENTS	DATE	REV
JB	FOR COORDINATION	15.05.2026	A

TAG LEGEND	
BIN1	WASTE BIN - RECESSED
BIN2	NAPPY BIN - IN CUPBOARD
BOL001	BOLLARD - FIXED
CFL01	CEILING - PLASTERBOARD
CFL03	CEILING - FIRE RATED
CLD004	PROFILED METAL SHEET CLADDING - REFER TO SECTION J REPORT
CLD005	DANPALON SINGLE GLAZED TRANSLUCENT CLADDING
COL	STRUCTURAL COLUMN - REFER STRUCTURAL ENGINEER
CON001	CONCRETE SLAB
CON002	CONCRETE SLAB - EXTERNAL HARDSTAND
CT1	CURTAIN TRACK
DP	DOWNPIPE
FH	DOUBLE PILLAR FIRE HYDRANT REFER HYD. ENG.
FHR	FIRE HOSE REEL REFER HYD. ENG.
FLW003	FLOOR DRAIN
GPO1	GPO SINGLE
GPOC	GPO SINGLE - CLEANERS
GT01	COLORBOND FOLDED STEEL GUTTER
GT02	KINGSPAN MEMBRANE LINED INSULATED GUTTER
M-FLT-1	M-FLT-1
M-FLT2	WET AREA TILES - FLOOR
M-TIL2	WET AREA - WALL TILE
M-VNL1	SHEET VINYL - FLOOR
MCT1	PRIVACY CURTAIN
MEC001	MECHANICAL DUCT - REFER MECHANICAL ENGINEER
MLV001	MECHANICAL EXHAUST LOUVRE
MR2	MIRROR 2
MR3	MIRROR 3
RPM001	INSULATED ROOF PANEL
RSS001	ROOF SAFETY SYSTEM
SCR001	POWDERCOATED ALUMINIUM SCREENING
SD3	SOAP DISPENSER
SNK2	SINK - CLEANERS
STR001	STRUCTURAL COLUMN - REFER STRUCTURAL ENGINEER
T1	WC STANDARD
T2	WC - AMBULANT
T4	WC - UNIVERSAL
THR1	TOILET ROLL HOLDER
TMV	THERMOSTATIC MIXING VALVE
TP1	TAP - WALL MOUNTED SENSOR
TRH2	TOILET ROLL HOLDER
UR4	URINAL - TROUGH
W 01	POWDERCOATED ALUMINIUM FRAMED COMMERCIAL GLAZING

Archipelago

Archipelago
Level 3, 159 George Street, Brisbane QLD 4000
T +617 3236 4806 www.archipelago.com.au
© ARCHIPELAGO ARCHITECTS PTY. LTD. All Rights Reserved
This work is copyright and cannot be reproduced or copied by any means without written permission of Archipelago Architects Pty Ltd. Any
whosoever is restricted by the terms of the agreement between Archipelago Architects Pt
y Ltd and the instructing party.

SKYGATE PLAY	
ROOF PLAN - PART A	
Drawn JB	Checked DC
Design Coordinated N/A	Compliance Checked N/A
Authorised For Issue DC	Construction Checked N/A



PROJECT NUMBER: NA260549
DATE: 25/05/2025
MARKUP: BAC SKYGATE PLAY
HYDRAULIC SERVICES PRELIM SKETCH