


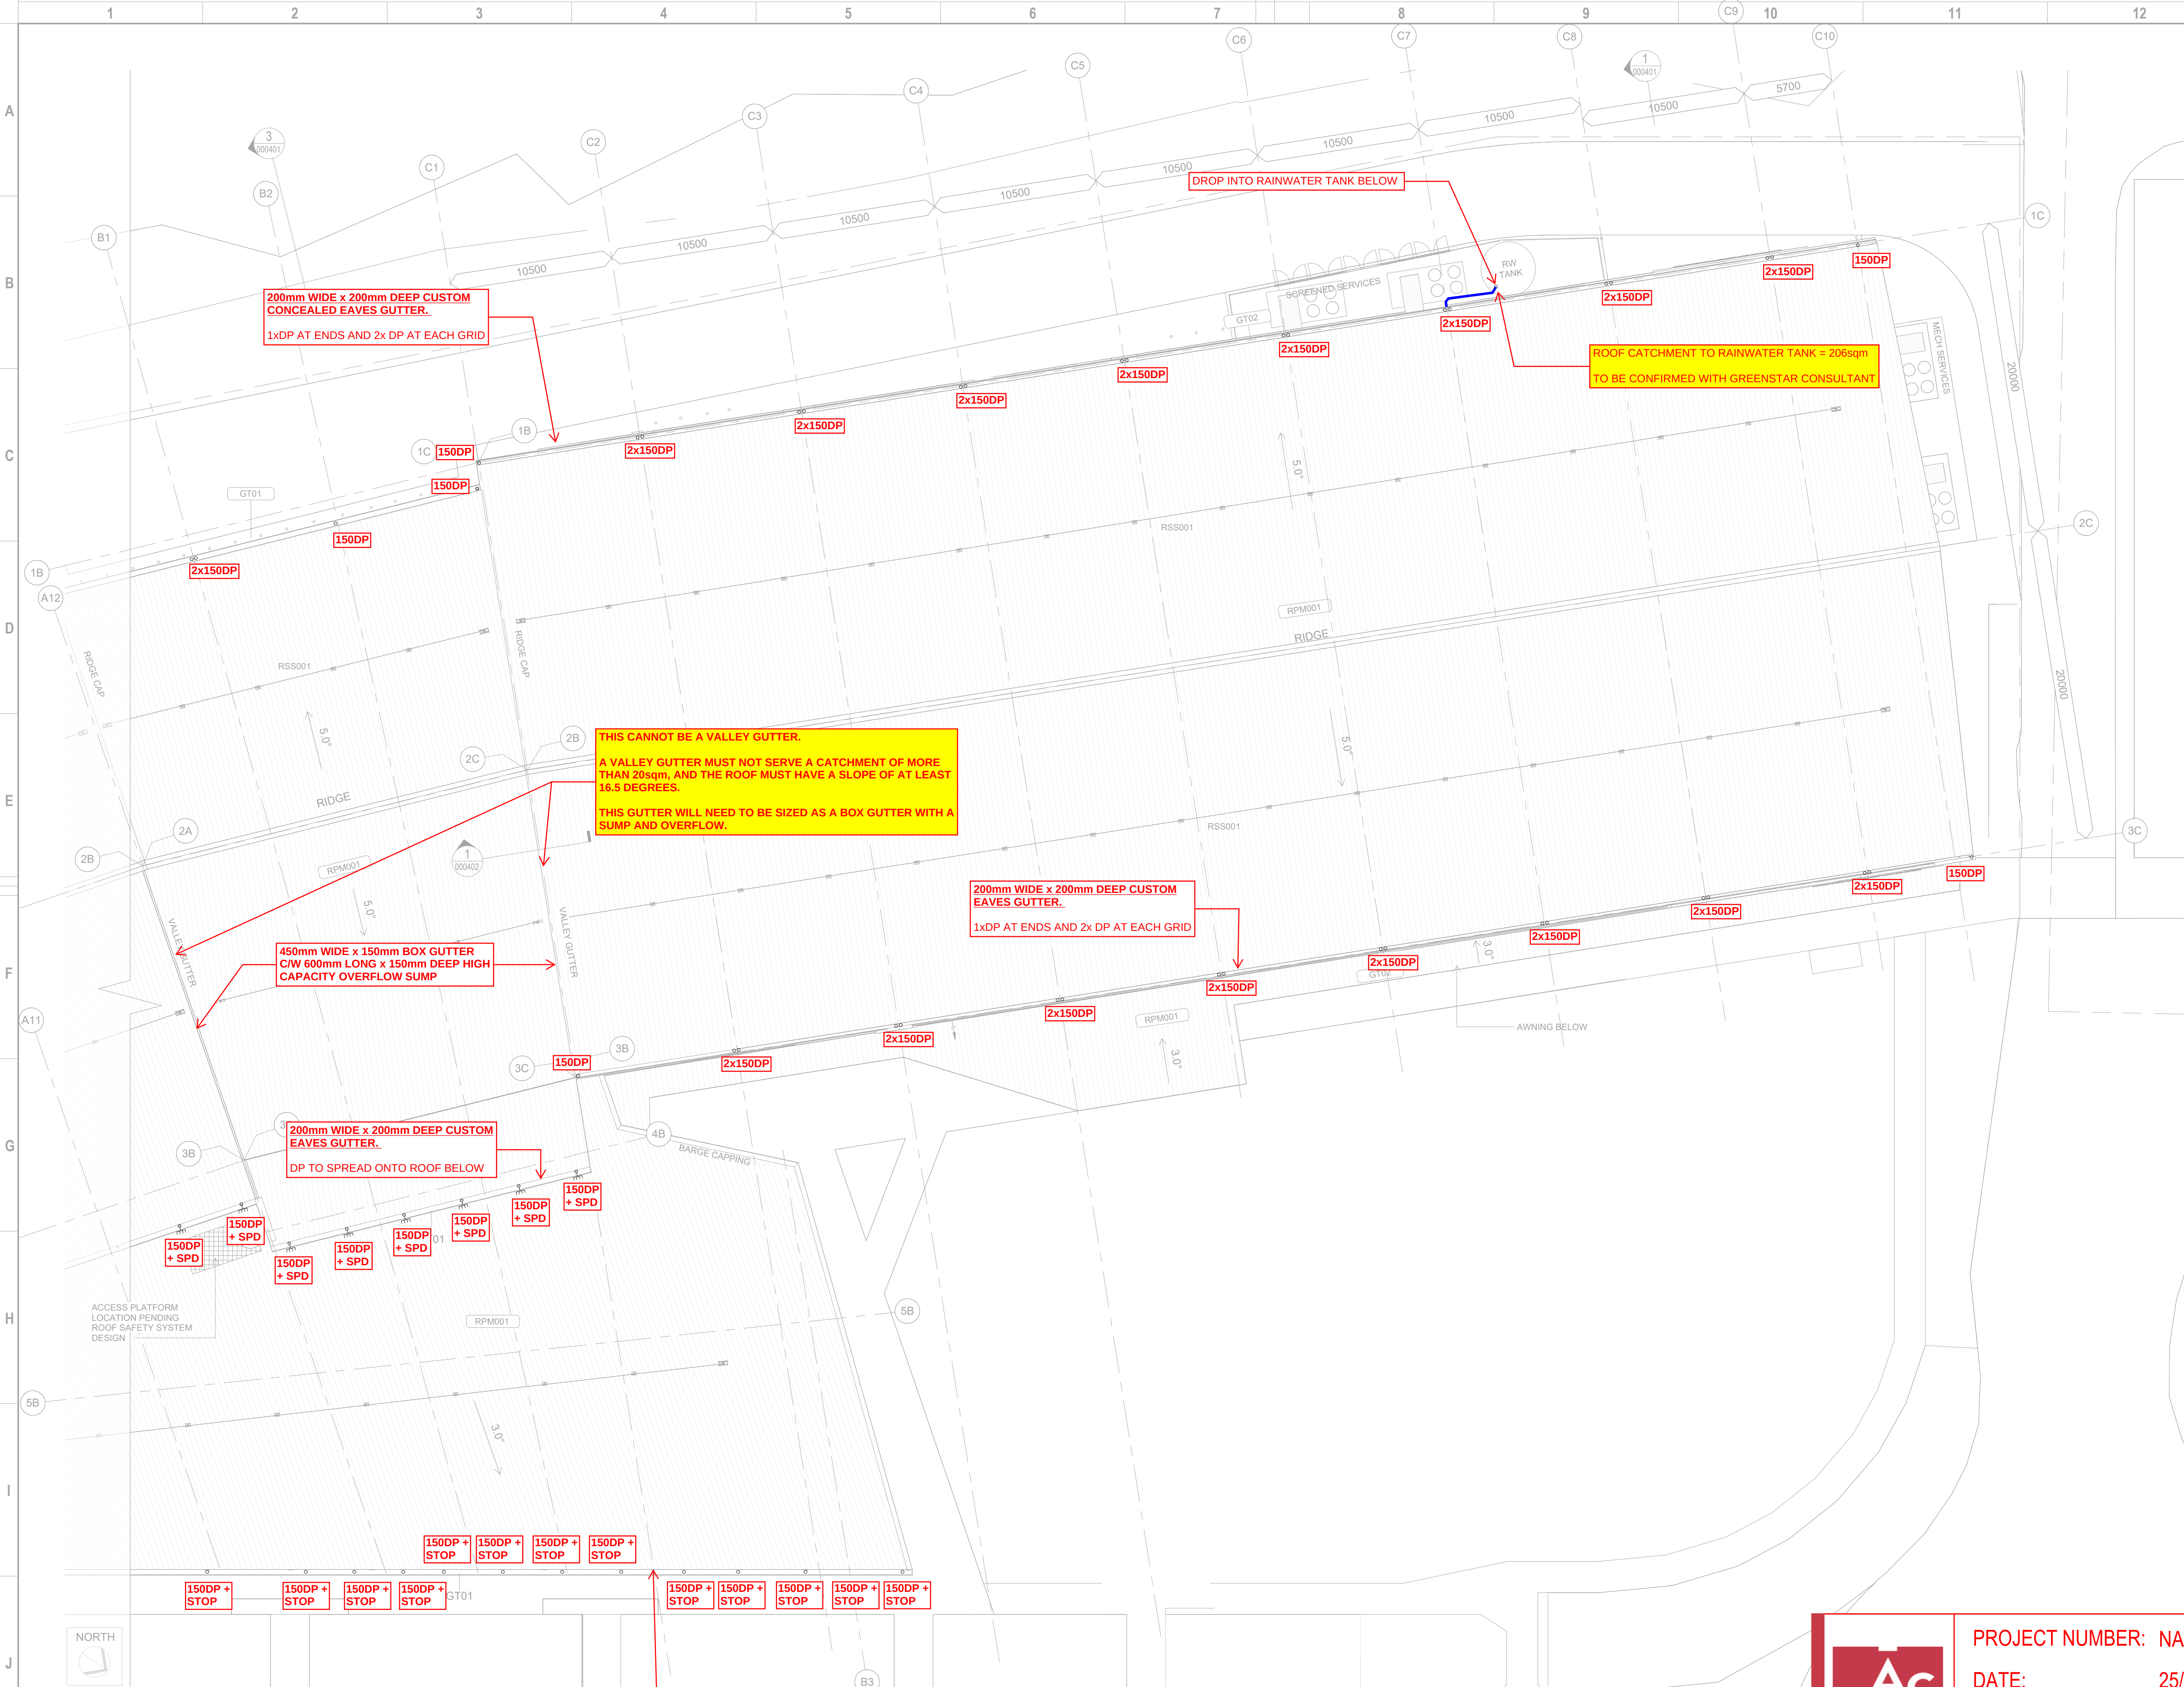

COPYRIGHT:
REPRODUCTION OF WHOLE OR PART OF THIS DOCUMENT
CONSTITUTES AN INFRINGEMENT OF COPYRIGHT. THE
INFORMATION, IDEAS AND CONCEPTS CONTAINED IN THIS
DOCUMENT ARE CONFIDENTIAL. THE RECIPIENT(S) OF
THIS DOCUMENT IS PROHIBITED FROM DISCLOSING SUCH
INFORMATION IDEAS AND CONCEPTS TO ANY PERSON
WITHOUT THE PRIOR WRITTEN CONSENT OF THE
BRISBANE AIRPORT CORPORATION PTY. LTD.

DRN	AMENDMENTS	DATE	REV
JB	FOR COORDINATION	15.05.2026	A

TAG LEGEND	
BCT1	Baby Change Tables
BIN1	WASTE BIN - RECESSED
BOL001	BOLLARD - FIXED
BOL002	BOLLARD - REMOVABLE
CFL01	CEILING - PLASTERBOARD
CLD004	PROFILED METAL SHEET CLADDING - REFER TO SECTION J REPORT
CLD005	DANPALON SINGLE GLAZED TRANSLUCENT CLADDING
CLD006	PRECAST CONCRETE
COL	STRUCTURAL COLUMN - REFER STRUCTURAL ENGINEER
CON001	CONCRETE SLAB
CON002	CONCRETE SLAB - EXTERNAL HARDSTAND
DP	DOWNPIPE
FH	DOUBLE PILLAR FIRE HYDRANT REFER HYD. ENG.
FHR	FIRE HOSE REEL REFER HYD. ENG.
FLW003	FLOOR DRAIN
GPOC	GPO SINGLE - CLEANERS
GT01	COLORBOND FOLDED STEEL GUTTER
GT02	KINGSPAN MEMBRANE LINED INSULATED GUTTER
M-FLT-1	WET AREA TILES - FLOOR
M-FTL2	WET AREA TILES - FLOOR
M-TIL2	WET AREA - WALL TILE
MEC001	MECHANICAL DUCT - REFER MECHANICAL ENGINEER
MR2	MIRROR 2
RPM001	INSULATED ROOF PANEL
RSS001	ROOF SAFETY SYSTEM
SCR001	POWDERCOATED ALUMINIUM SCREENING
SD3	SOAP DISPENSER
SNK2	SINK - CLEANERS
STR001	STRUCTURAL COLUMN - REFER STRUCTURAL ENGINEER
T1	WC STANDARD
T2	WC - AMBULANT
T4	WC - UNIVERSAL
THR1	TOILET ROLL HOLDER
TMV	THERMOSTATIC MIXING VALVE
TP1	TAP - WALL MOUNTED SENSOR
TRH2	TOILET ROLL HOLDER
UR1	URNAL - WALL HUNG
W.01	POWDERCOATED ALUMINIUM FRAMED COMMERCIAL GLAZING

Archipelago

Archipelago
Level 3, 159 George Street, Brisbane QLD 4000
T +617 3236 4806 www.archipelago.com.au
© ARCHIPELAGO ARCHITECTS PTY LTD. All Rights Reserved
This work is copyright and cannot be reproduced or copied by any means without written permission of Archipelago Architects Pty Ltd. Any
whichever is restricted to the terms of the agreement between Archipelago Architects Pt
y Ltd and the instructing party.

SKYGATE PLAY

ROOF PLAN - PART B

Drawn JB	Checked DC
Design Coordinated N/A	Compliance Checked N/A
Authorised For Issue DC	Construction Checked N/A



PROJECT NUMBER: NA260549
DATE: 25/05/2025
MARKUP: BAC SKYGATE PLAY
HYDRAULIC SERVICES PRELIM SKETCH