


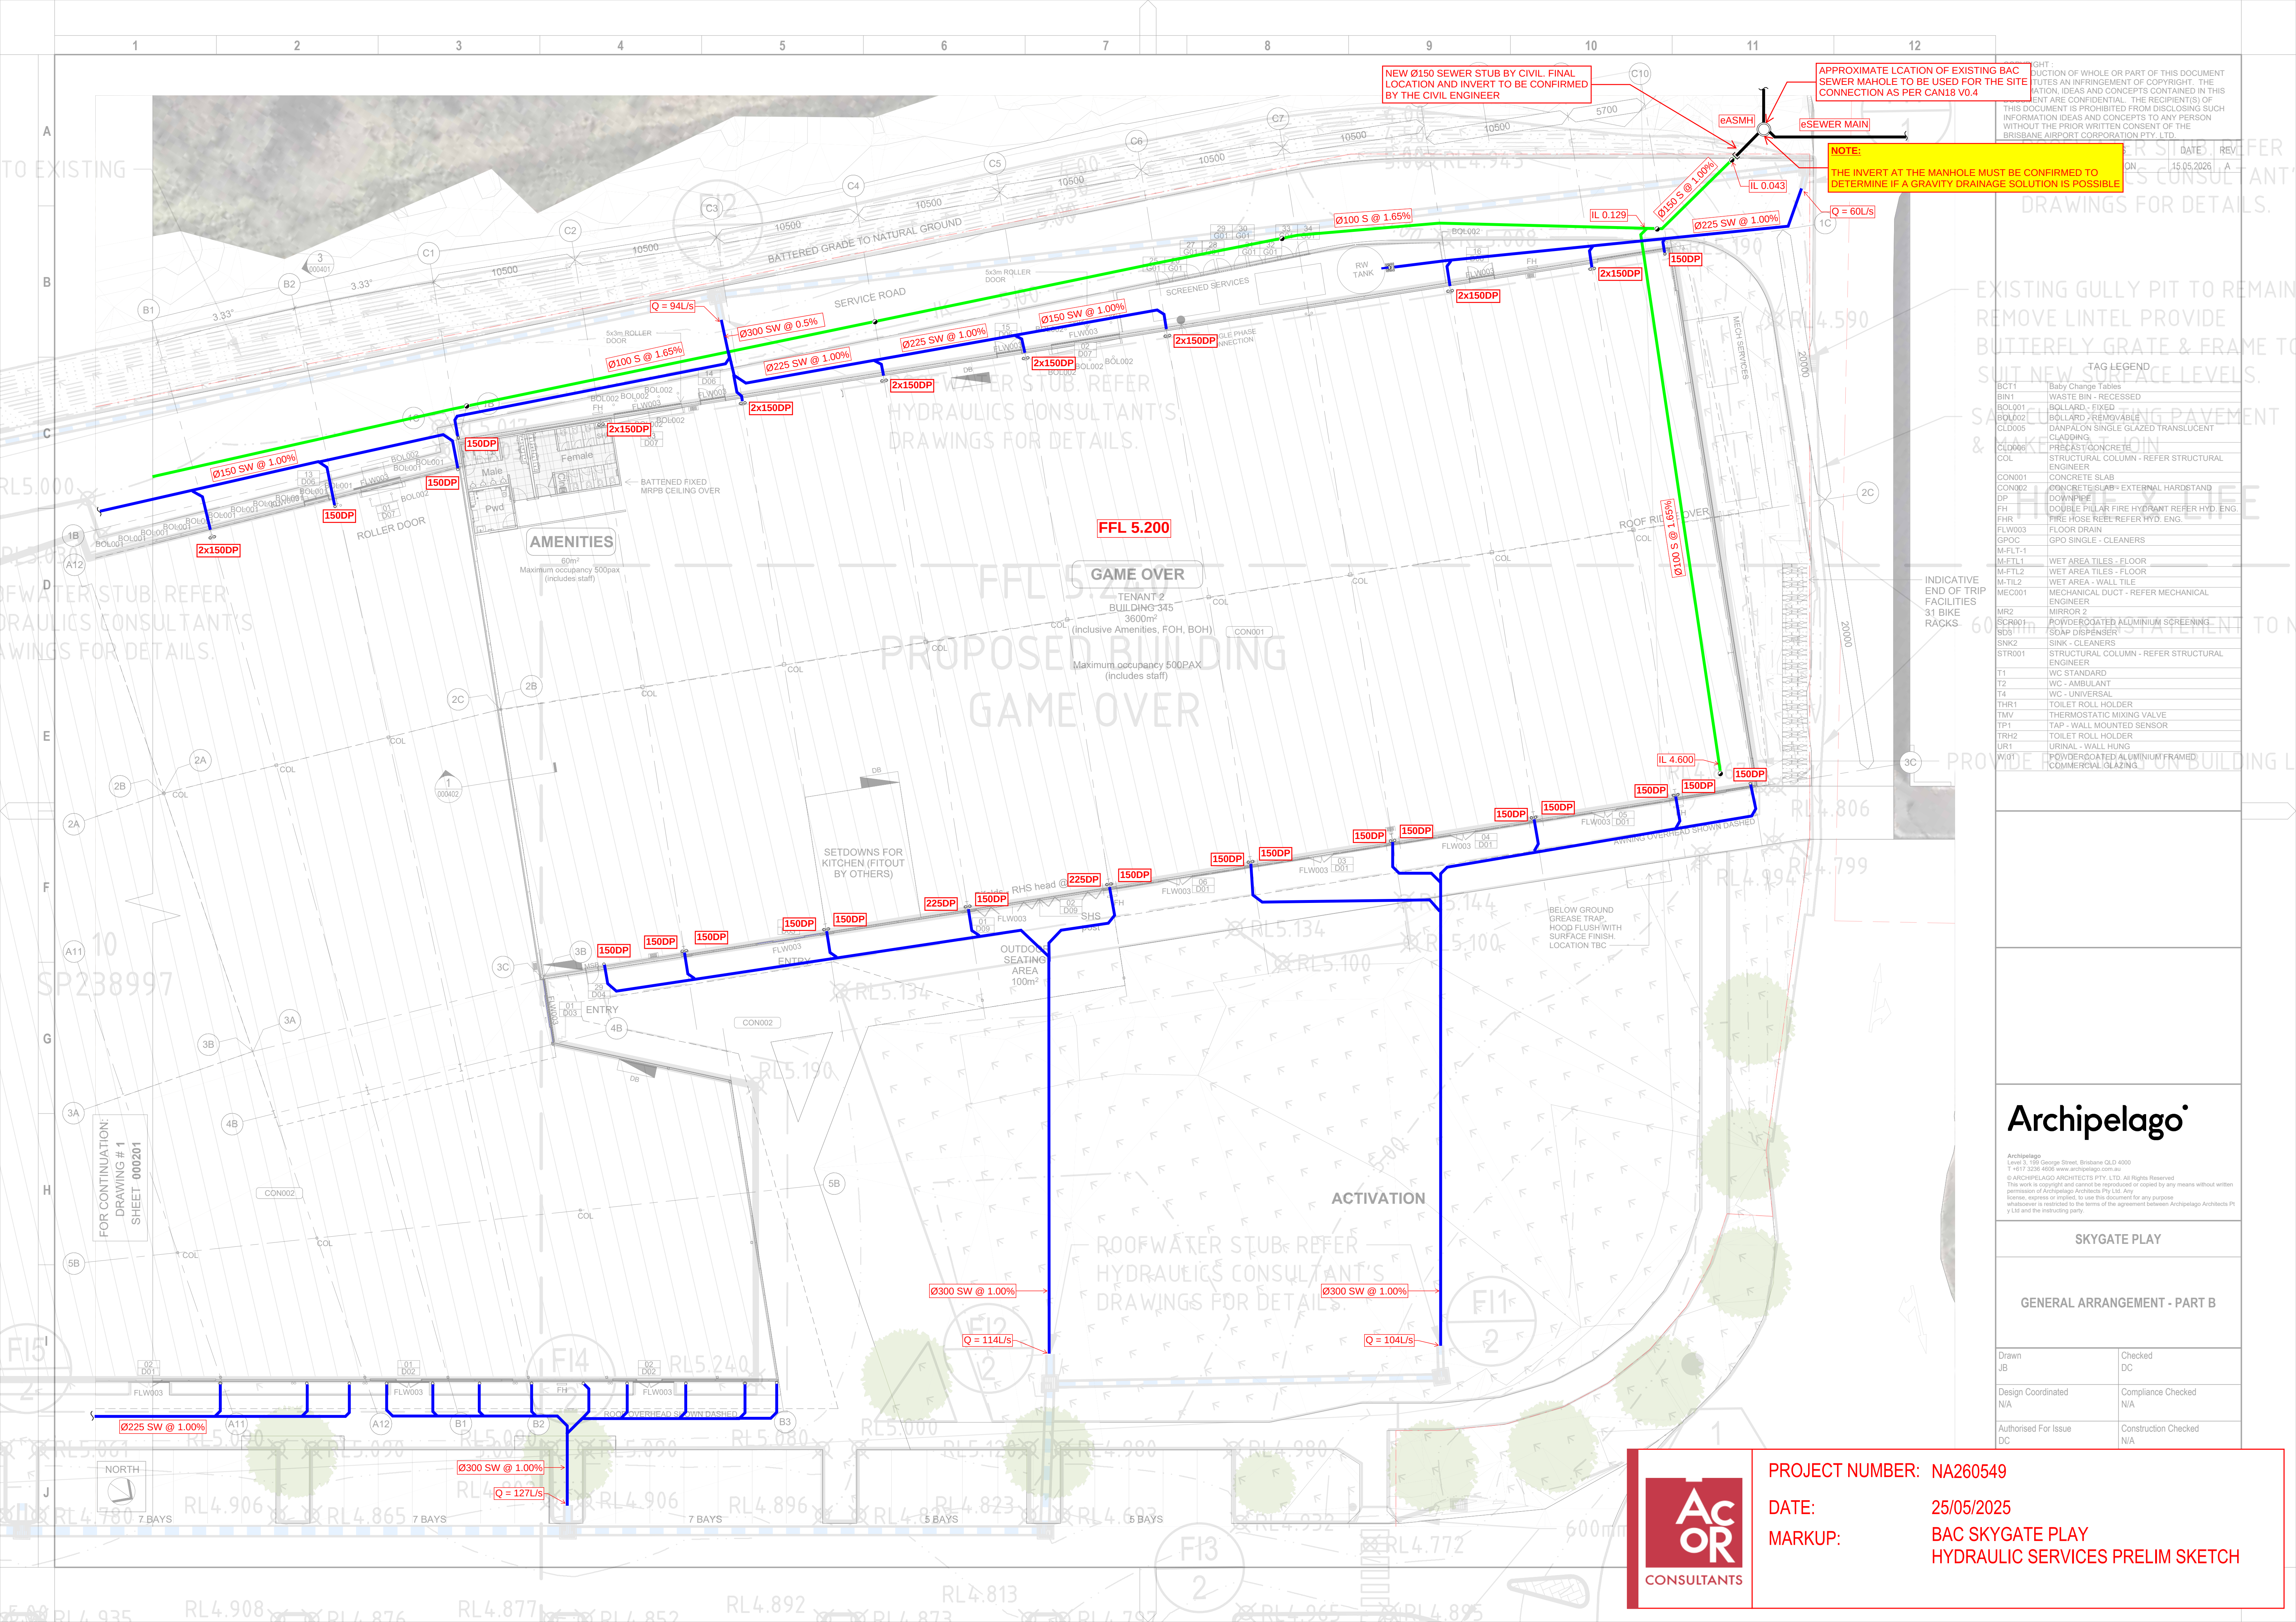


NOTE: THE INVERT AT THE MANHOLE MUST BE CONFIRMED TO DETERMINE IF A GRAVITY DRAINAGE SOLUTION IS POSSIBLE

TAG LEGEND	
BCT1	Baby Change Tables
BINT	WASTE BIN - RECESSED
BOL001	BOLLARD - FIXED
BOL002	BOLLARD - REMOVABLE
CLD005	DANPALON SINGLE GLAZED TRANSLUCENT CLADDING
CLD006	PRECAST CONCRETE STRUCTURAL COLUMN - REFER STRUCTURAL ENGINEER
CON001	CONCRETE SLAB
CON002	CONCRETE SLAB - EXTERNAL HARDSTAND
DP	DOWNPIPE
FH	DOUBLE PILLAR FIRE HYDRANT REFER HYD. ENG.
FHR	FIRE HOSE REEL REFER HYD. ENG.
FLW003	FLOOR DRAIN
GPOC	GPO SINGLE - CLEANERS
M-FLT-1	WET AREA TILES - FLOOR
M-FLT-2	WET AREA TILES - FLOOR
M-TIL-2	WET AREA - WALL TILE
MEC001	MECHANICAL DUCT - REFER MECHANICAL ENGINEER
MR2	MIRROR 2
SCR001	POWDERCOATED ALUMINIUM SCREENING
SD3	SOAP DISPENSER
SNK2	SINK - CLEANERS
STR001	STRUCTURAL COLUMN - REFER STRUCTURAL ENGINEER
T1	WC STANDARD
T2	WC - AMBULANT
T4	WC - UNIVERSAL
THR1	TOILET ROLL HOLDER
TMV	THERMOSTATIC MIXING VALVE
TP1	TAP - WALL MOUNTED SENSOR
TRH2	TOILET ROLL HOLDER
UR1	URINAL - WALL HUNG
W01	POWDERCOATED ALUMINIUM FRAMED COMMERCIAL GLAZING

Archipelago

Archipelago
Level 3, 159 George Street, Brisbane QLD 4000
T +61 7 3236 4805 www.archipelago.com.au
© ARCHIPELAGO ARCHITECTS PTY LTD. All Rights Reserved
This work is copyright and cannot be reproduced or copied by any means without written permission of Archipelago Architects Pty Ltd. Any reuse or misappropriation of this work without the written permission of Archipelago Architects Pty Ltd is prohibited.

SKYGATE PLAY

GENERAL ARRANGEMENT - PART B

Drawn JB	Checked DC
Design Coordinated N/A	Compliance Checked N/A
Authorised For Issue DC	Construction Checked N/A

PROJECT NUMBER: NA260549
DATE: 25/05/2025
MARKUP: BAC SKYGATE PLAY
HYDRAULIC SERVICES PRELIM SKETCH

